


Appl. No. 09/651,979  
Amdt. dated May 20, 2004  
Reply to Office Action of February 26, 2004

Proposed Amendments to the Drawings:

A redlined proposed drawing correction of Figs. 1 and 4 is submitted herewith for the Examiner's approval. In Fig. 1, the numerals 16, 26, and 28 have been removed from within their respective boxes and the boxes are now labeled with the same numerals connected thereto with lead lines. This change makes room for text labels. The boxes 16, 26, and 28 have been labeled with the text "non-volatile memory", "dynamic heap", and "storage area", respectively. In Fig. 4, the numerals 10, 54, 56, and 58 have been removed from within their respective boxes and the boxes are now labeled with the same numerals connected thereto with lead lines. This change makes room for text labels. The boxes 10, 54, 56, and 58 have been labeled with the text "PDA", "IR Converter", "UI", and "Controller", respectively. Fig. 4 also has been amended to add element 34, the encryption program described at page 7, lines 16 and 17 of the present specification and claimed in claim 1 as presently amended.

REDLINED PROPOSED  
DRAWING CORRECTION  
APPL. NO. 09/051,979

**FIG. 1**

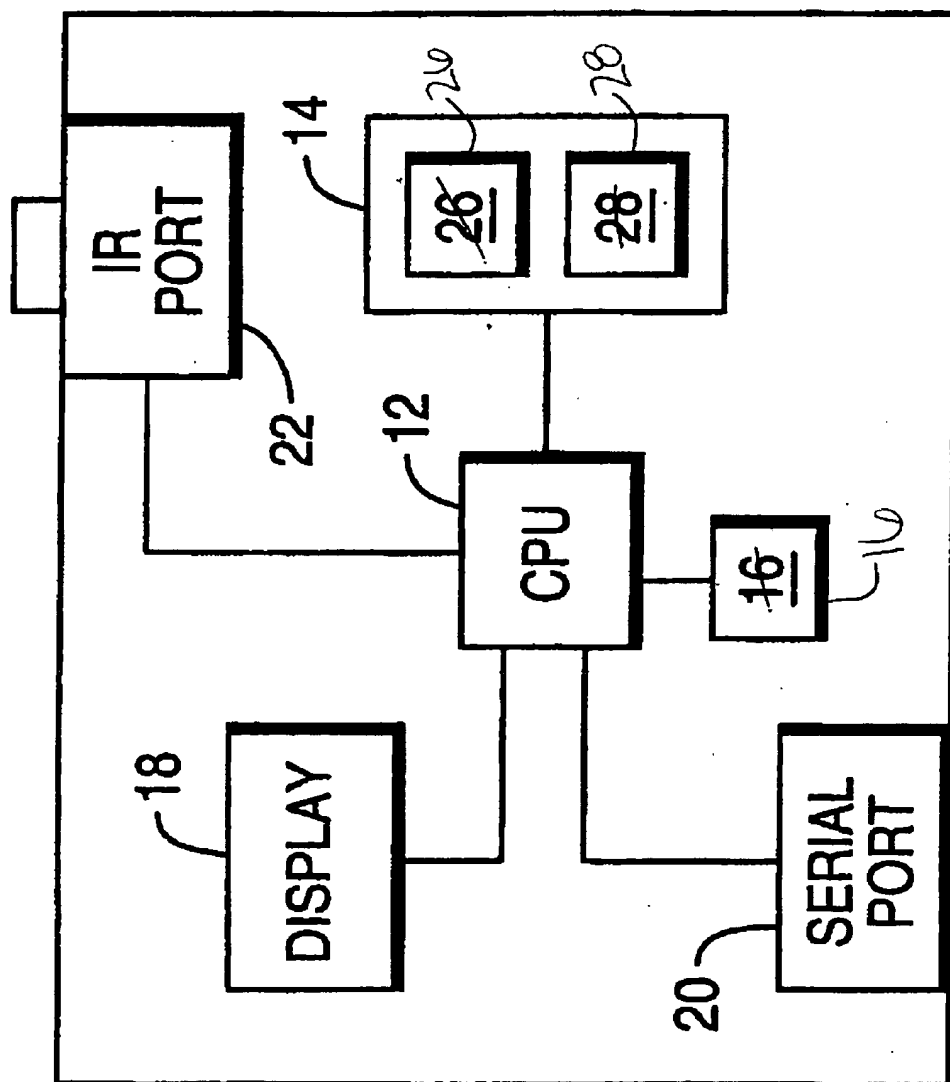

In box 16, insert text "non-volatile memory."  
 In box 26, insert text "dynamic heap."  
 In box 28, insert text "storage area."

REDLINED PROPOSED  
DRAWING CORRECTION  
APP1. NO. 09/051,979

